




- NOTES:
1. TREE PROTECTION FENCE SHALL BE INSTALLED PRIOR TO ANY SITE WORK, CLEARING OR DEMOLITION.
  2. SUPER SILT FENCE MAY BE USED IN LIEU OF WELDED WIRE FOR TREE PROTECTION PROVIDED IT IS INSTALLED AND MAINTAINED AS A TREE PROTECTION MEASURE AND IS POSTED WITH TREE PROTECTION SIGNS.
  3. TREE PROTECTION FENCE SHALL BE MAINTAINED THROUGHOUT CONSTRUCTION. REMOVE FENCE ONLY WITH APPROVAL AND AFTER ALL SITE WORK HAS BEEN COMPLETED.

1 CHAIN LINK TREE PROTECTION FENCE (TYPICAL)  
LJ-103 SCALE: NTS

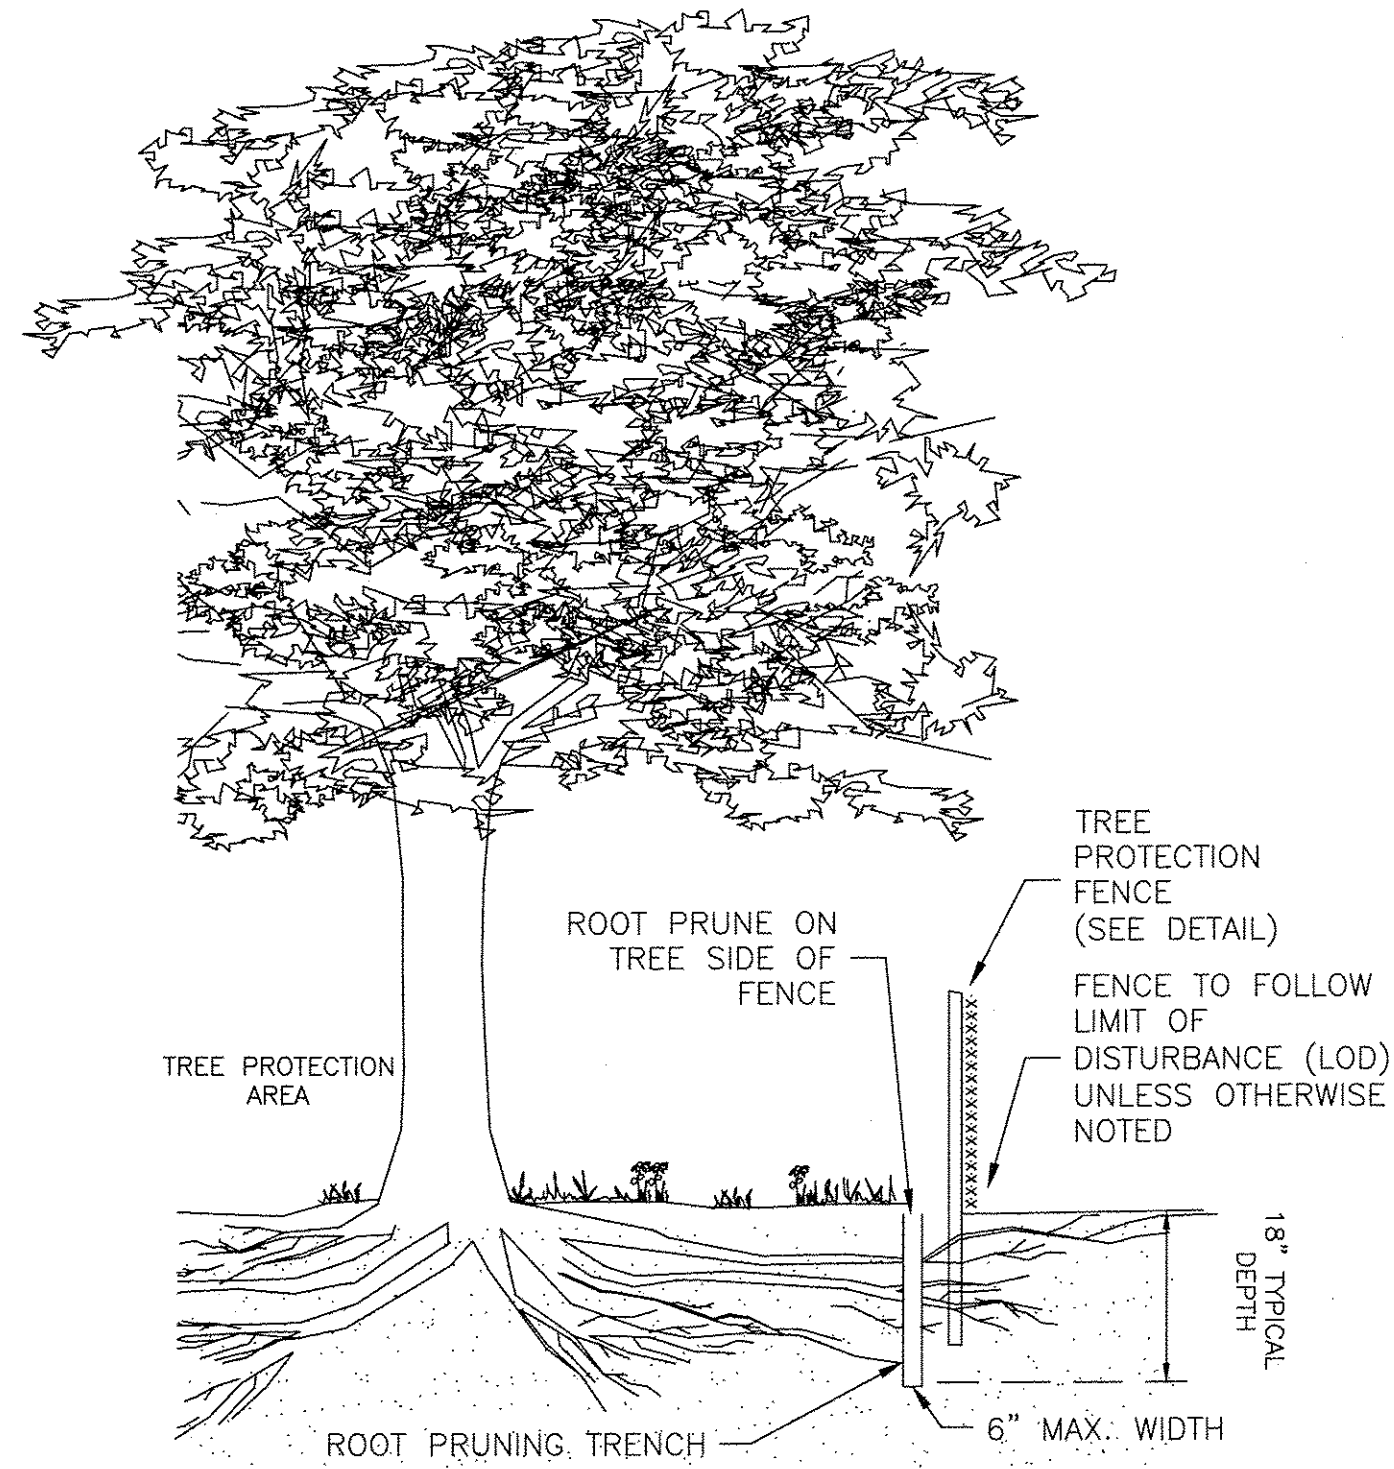

- NOTES:
1. TREE PROTECTION AREA WILL BE DETERMINED AS PART OF THE PLAN REVIEW PROCESS. EXACT LOCATION, DEPTH AND METHODS OF ROOT PRUNING TO BE DETERMINED IN THE FIELD BY PROJECT ARBORIST.
  2. EXACT LOCATION OF TREE PROTECTION AREAS SHALL BE STAKED OR FLAGGED PRIOR TO TRENCHING.
  3. TRENCH SHOULD BE BACKFILLED IMMEDIATELY OR INCORPORATED WITH SILT FENCE INSTALLATION.
  4. ROOTS SHOULD BE SEVERED BY TRENCHER, VIBRATORY FLOW OR APPROVED EQUIVALENT. ROOTS OVER 1.5" DIAMETER SHOULD BE CLEANLY CUT BY HAND. ROOT PRUNING ADJACENT TO SPECIMEN TREES MAY REQUIRE SOIL REMOVAL BY SUPERSONIC AIR TOOL TO MINIMIZE TREE AND ROOT IMPACTS.

2 ROOT PRUNING (TYPICAL)  
LJ-103 SCALE: NTS

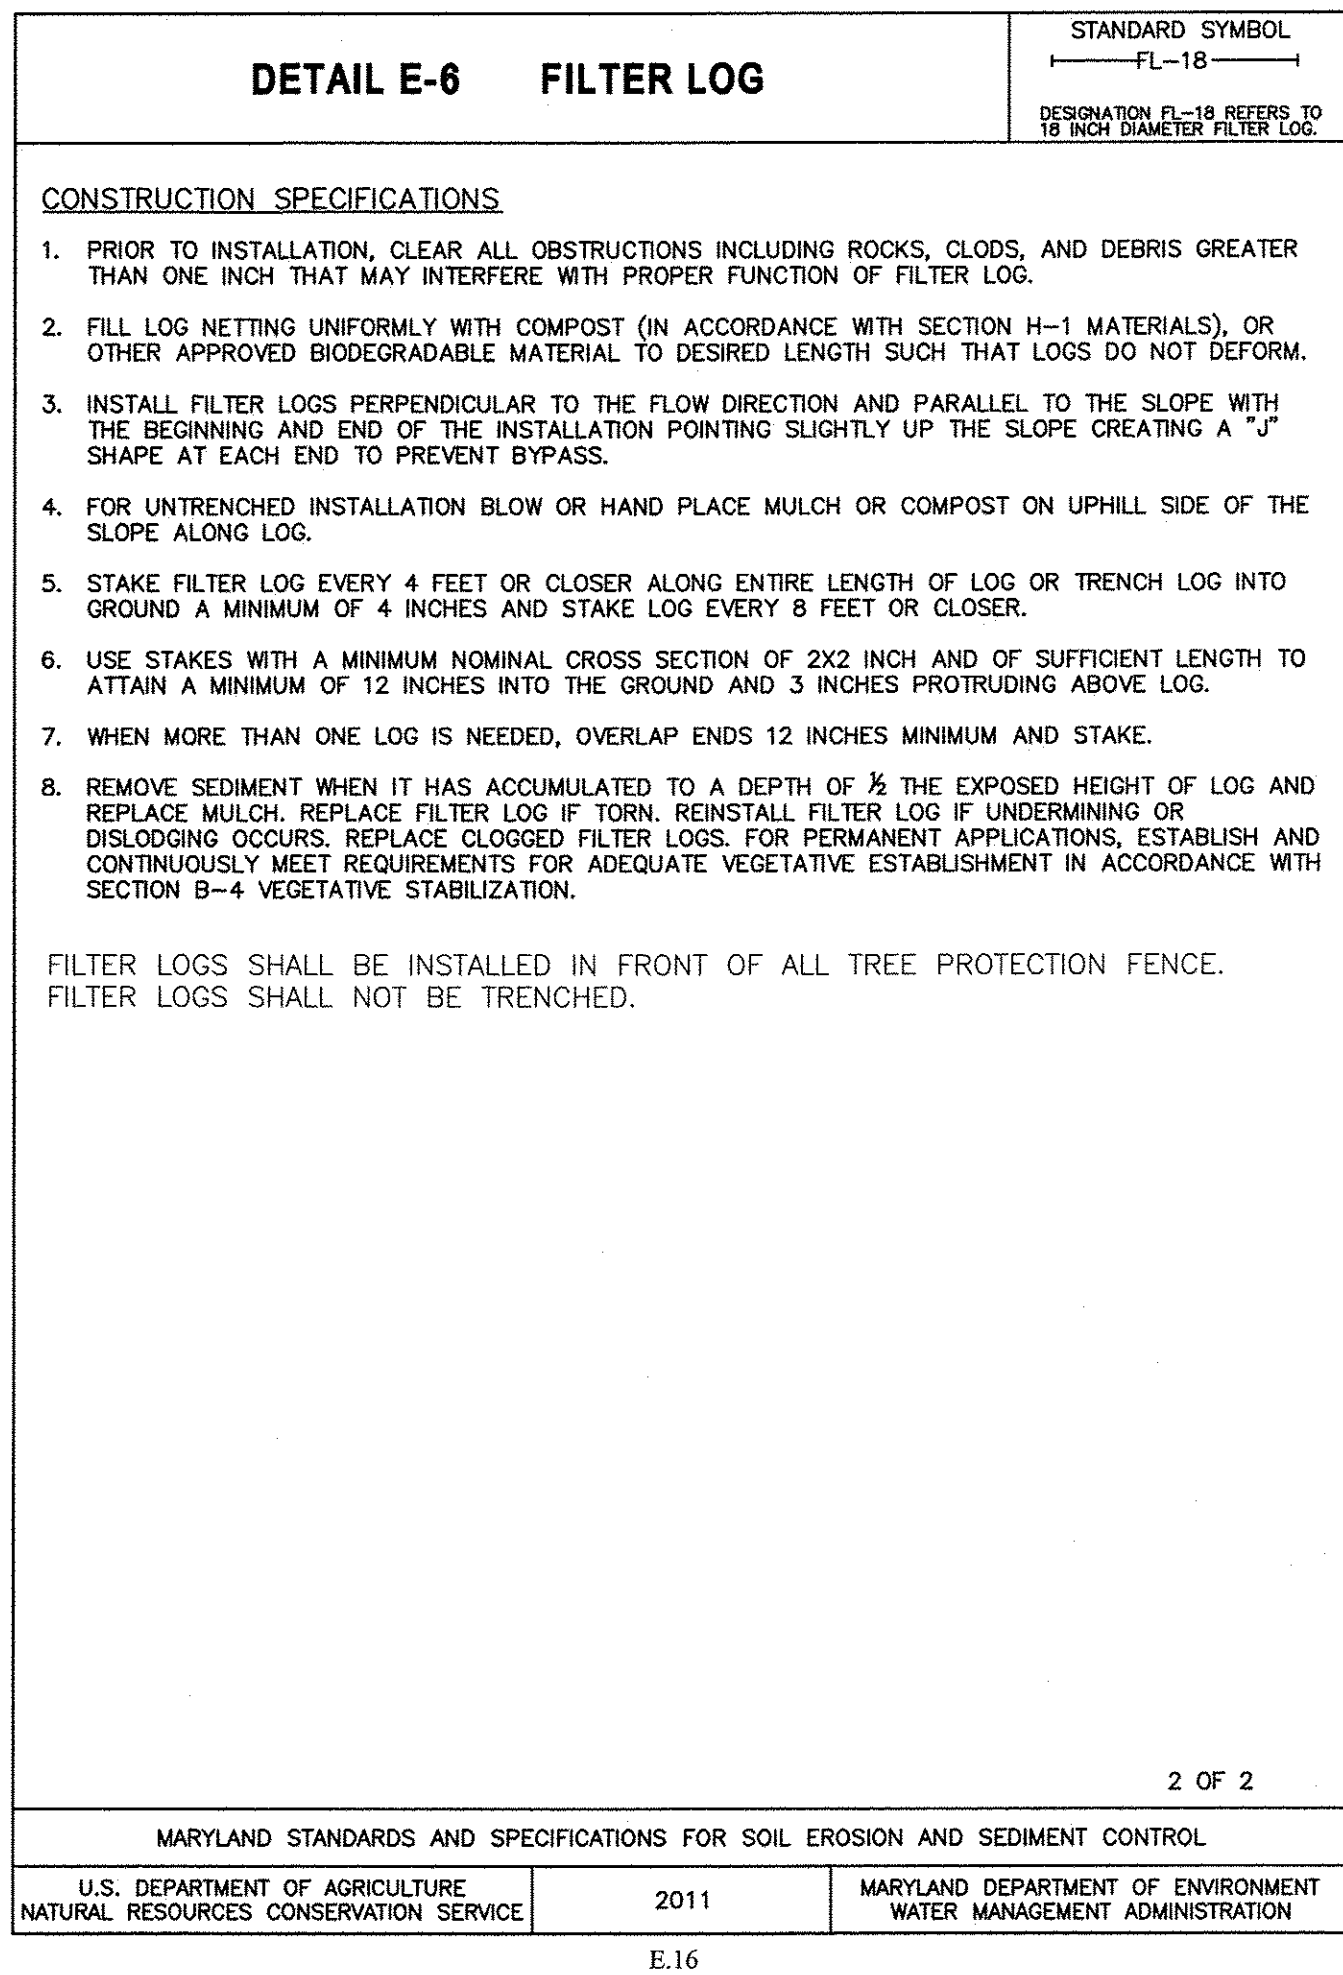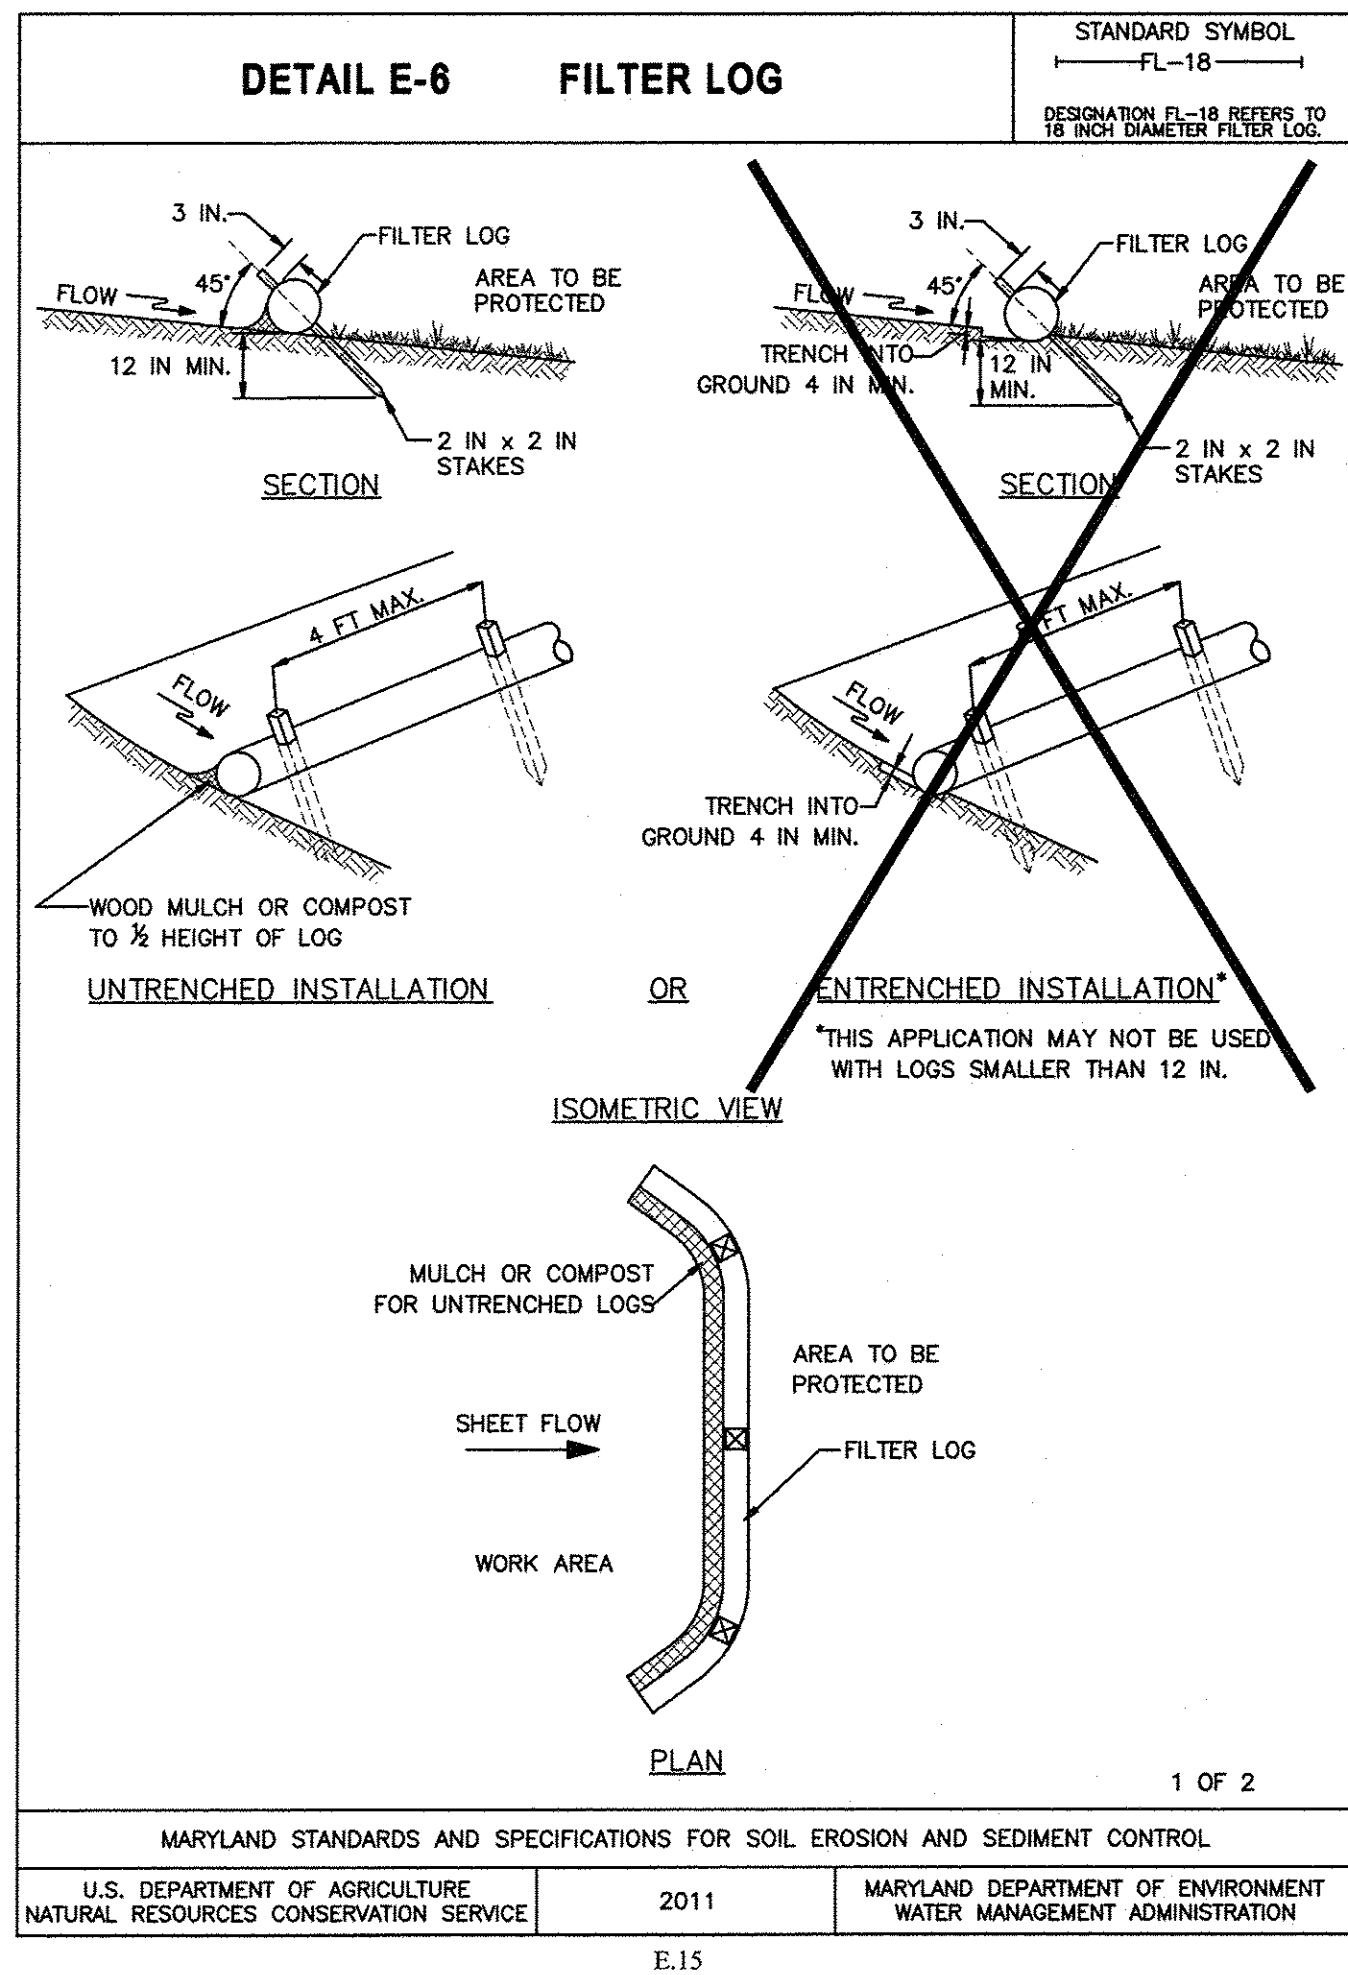

DRAWN: C.J.H.	REV. NO. 3
DESIGN: C.J.H.	
CHECKED: C.A.C.	

BASED ON PLANS PROVIDED BY BAY ENGINEERING

NO.	DATE	BY	COMMENT
1	1/13/2013	CH	PER CITY COMMENT AND REISED OIL
2	2/6/2014	CH	PER CITY COMMENT AND REISED OIL
3	4/16/2014	CH	PER CITY COMMENT AND REISED OIL

STATE OF MARYLAND  
LICENSED FORESTER  
NO. 323  
CHRISTOPHER COLLIER  
BOARD OF FORESTERS  
4/16/2014

Land Development Solutions  
2138 Priest Bridge Ct. Suite 4, Crofton, MD 21114  
Office 410.774.0024 • Fax 310.958.0184  
National 877.876.1251

DAVEY  
RESOURCE GROUP  
A Division of The Davey Tree Expert Company

PRELIMINARY  
FOREST CONSERVATION PLAN

PRIMROSE HILL  
3 MILKSHAKE LANE  
CITY OF ANNAPOLIS, MARYLAND

ELM STREET DEVELOPMENT

SCALE: 1" = 30'

DATE: 07/02/2013

SHEET NO: LJ-103